


LABOR AND MATERIALS

1	Copper Lead	} Connection <sup>3/4</sup>	\$
1	Curb		} Cock Valve } <sup>3/4</sup> in.
		T. S. & V.	
1	Service box	} Short 3 1/2 x 4 1/2	\$
	Old returned		
		Buff or Rdway	
32	Ft. <sup>3/4</sup> in.	} Copper	\$
		C.I.	
		C.I.	
	Nipples	in. at	\$
	Bushings	to in. at	\$
	Red'g	} Coupl'gs	to in. at \$
	Inc'g		
	Union	in. at	\$
	Meter	in. at	\$
	Lead Joints	at	\$
	Compound Joints	at	\$
	Maintenance Foreman		\$
	Hrs. Water Maint. Man-1	at	\$
	Hrs. Water Maint. Man-2	at	\$
	Hrs. Garage Foreman	at	\$
	Hrs. Labor	at	\$
	Hrs. Compressor	at	\$
	Compensation Ins. at \$	per C	\$
	Trucking		\$
	Pav't Patch		\$
			\$
			\$
	O'head		\$
			\$

St. PL  
PL  
 Ave. No 128  
 Name of Owner BAY  
 TAX ID # 302.16-12-8

Labor and Mat'l. Report 19

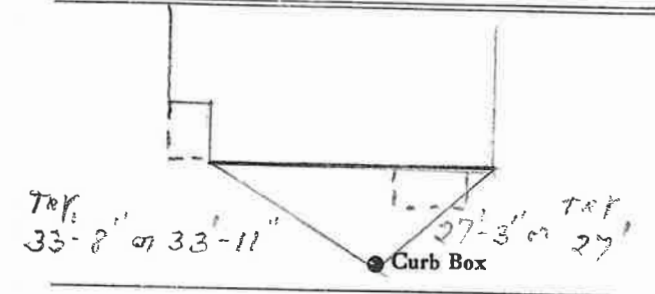

6 Main Elev. of Main at tap 5 1/2  
 Gate at ● ● Gate at

● Curb Box