

LABOR AND MATERIALS

1	Copper Lead	} Connection	<u>3/4</u>		\$
1	Curb	} Cock Valve T.S. & V.	} <u>3/4 in.</u>		\$
1	Service box Old returned	{ Short 3 1/2 <u>4 1/2</u> Long 4 1/2 x 5 1/2 Buff or Rdway			\$
44	Ft. <u>3/4</u> in.	{ Copper G.I. C.I.	} Pipe at		\$
	Nipples	in. at			\$
	Bushings	to in. at			\$
	Red'g Inc'g	} Coupl'gs	to in. at		\$
	Union	in. at			\$
	Meter	in. at			\$
	Lead Joints	at			\$
	Compound Joints	at			\$
	Maintenance Foreman				\$
	Hrs. Water Maint. Man-1	at			\$
	Hrs. Water Maint. Man-2	at			\$
	Hrs. Garage Foreman	at			\$
	Hrs. Labor--	at			\$
	Hrs. Compressor	at			\$
	Compensation Ins. at \$	per C			\$
	Trucking				\$
	Pav't Patch				\$
					\$
					\$
					\$
	O'head				\$
					\$


St.
Pt.
Ave. No. 130

BAY

Name of Owner _____

TAX ID # 302.16-12-9

Labor and Mat'l. Report 19

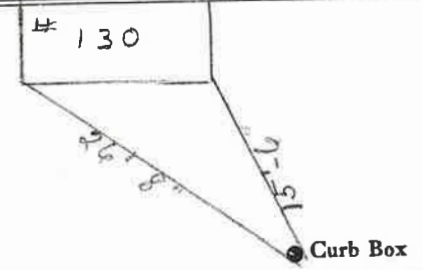

6 Main Elev. of Main at tap 5

Gate at ● ● Gate at

● Curb Box