


LABOR AND MATERIALS

_____	Copper } Connection _____	\$ _____
_____	Lead } _____	\$ _____
_____	Curb } Cock _____	\$ _____
_____	Valve } _____ in. _____	\$ _____
_____	T.S. & V. } _____	\$ _____
_____	Service box { Short 3-1/2 x 4-1/2 } _____	\$ _____
_____	Old returned { Long 4-1/2 x 5-1/2 } _____	\$ _____
_____	Ft. _____ in. { Copper } Pipe at _____	\$ _____
_____	G.I. } _____	\$ _____
_____	C.I. } _____	\$ _____
_____	Nipples _____ in. at _____	\$ _____
_____	Bushings _____ to _____ in. at _____	\$ _____
_____	Red'g _____	\$ _____
_____	Inc'g _____	\$ _____
_____	Union _____ in. at _____	\$ _____
_____	Meter _____ in. at _____	\$ _____
_____	_____	\$ _____
_____	Compound Joints at _____	\$ _____
_____	Maintenance Foreman _____	\$ _____
_____	Hrs. Water Maint. Man - 1 at _____	\$ _____
_____	Hrs. Water Maint. Man - 2 at _____	\$ _____
_____	Hrs. Garage Foreman _____ at _____	\$ _____
_____	Hrs. Labor _____ at _____	\$ _____
_____	Hrs. Compressor at _____	\$ _____
_____	_____	\$ _____
_____	Trucking _____	\$ _____
_____	Pav't Patch _____	\$ _____
_____	_____	\$ _____
_____	_____	\$ _____
- St. Bay St
Pl. Ave. No. 132

Name of Owner _____
TAX ID # 302.16-12-10

Labor and Mat'l. Report 19 _____

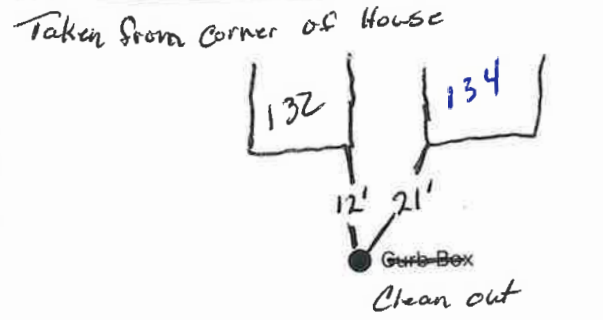

_____ Main Elev. of Main at tap _____

Gate at ● Gate at ●

● Curb Box

LABOR AND MATERIALS


/	Copper	}	Connection	<u>3/4</u>		\$
	Lead					
/	Curb	}	Cock	<u>3/4</u> in.		\$
			Valve			
			T.S. & V.			
/	Service box	}	Short 3 1/2 x 4 1/2			
	Old returned		Long 4 1/2 x 5 1/2			
			Buff. or Rdway			\$
32	Ft.	}	Copper			
	<u>3/4</u> in.		C.I.	Pipe at		\$
			C.I.			
	Nipples		in. at			\$
	Bushings		to in. at			\$
	Red'g	}	Coupl'gs	to in. at		\$
	Inc'g					
	Union		in. at			\$
	Meter		in. at			\$
	Lead Joints		at			\$
	Compound Joints		at			\$
	Maintenance Foreman					\$
	Hrs. Water Maint. Man		—1 at			\$
	Hrs. Water Maint. Man		—2 at			\$
	Hrs. Garage Foreman		at			\$
	Hrs. Labor		at			\$
	Hrs. Compressor		at			\$
	Compensation Ins.		at \$	per C		\$
	Trucking					\$
	Pav't Patch					\$
						\$
						\$
	O'head					\$
						\$

St. PH
Ave. No. 132

BAY-

Name of Owner _____

Labor and Mat'l. Report 19

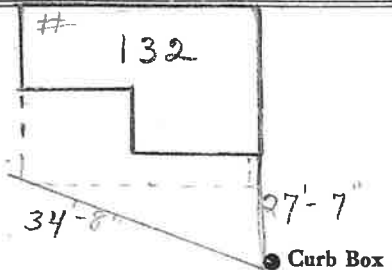

● Curb Box

6 Main

Elev. of Main at tap 5 1/2

Gate at ●

● Gate at

● Curb Box