


### LABOR AND MATERIALS

1	Copper <del>Lead</del>	} Connection	<u>3/4</u>		\$
1	Curb	} Cock Valve T.S. & V.	} <u>3/4</u> in.		\$
1	Service box Old returned	} Short $3\frac{1}{2} \times 4\frac{1}{2}$ Long $4\frac{1}{2} \times 5\frac{1}{2}$ Buff or Rdway			\$
31	Ft. <u>3/4</u> in.		} Copper <del>C.I.</del> C.I.	} Pipe at	
	Nipples	in. at			\$
	Bushings	to in. at			\$
	Red'g Inc'g	} Coupl'gs	to in. at		\$
	Union		in. at		\$
	Meter	in. at		\$	
	Lead Joints	at		\$	
	Compound Joints	at		\$	
	Maintenance Foreman			\$	
	Hrs. Water Maint. Man-1	at		\$	
	Hrs. Water Maint. Man-2	at		\$	
	Hrs. Garage Foreman	at		\$	
	Hrs. Labor	at		\$	
	Hrs. Compressor	at		\$	
	Compensation Ins. at \$	per C		\$	
	Trucking			\$	
	Pav't Patch			\$	
				\$	
				\$	
	O'head			\$	
				\$	

St. PI.  
Ave. No. 136

BAY  
Name of Owner  
TAX ID # 302.16-12-12

Labor and Mat'l. Report 19

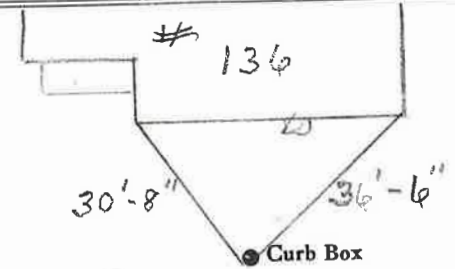

6 Main Elev. of Main at tap 5  
Gate at ● ● Gate at

● Curb Box