


LABOR AND MATERIALS

1	Copper	} Connection	3/4	\$	
	Lead				
1	Curb	} Cook Valve T.S. & V.	3/4 in.	\$	
1	Service box	} Short 3 1/2 x 4 1/2 Long 4 1/2 x 5 1/2 Buff or Rdway		\$	
	Old returned				
10	Ft.	} Copper C.I. C.I.	3/4 in.	} Pipe at	\$
	Nipples	in. at		\$	
	Bushings	to in. at		\$	
	Red'g	} Coupl'gs	to in. at	\$	
	Inc'g				
	Union	in. at		\$	
	Meter	in. at		\$	
	Lead Joints	at		\$	
	Compound Joints	at		\$	
	Maintenance Foreman			\$	
	Hrs. Water Maint. Man-1	at		\$	
	Hrs. Water Maint. Man-2	at		\$	
	Hrs. Garage Foreman	at		\$	
	Hrs. Labor-	at		\$	
	Hrs. Compressor	at		\$	
	Compensation Ins. at \$	per C		\$	
	Trucking			\$	
	Pav't Patch			\$	
				\$	
				\$	
	O'head			\$	
				\$	

St. 134Y
~~Pl.~~
 Ave. No. 137

Name of Owner _____
 TAX ID # 302.16-15-25

Labor and Mat'l. Report 19

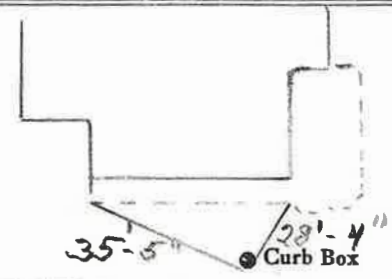

6 Main Elev. of Main at tap 5 1/2

Gate at • • Gate at

• Curb Box