


LABOR AND MATERIALS

Copper	} Connection	_____	\$ _____	
Lead				
Curb	} Cock Valve	_____ in.	\$ _____	
				T. S. & V.
Service box	} Short 3½ x 4½	_____	\$ _____	
Old returned				Long 4½ x 5½
				Buff or Rdway
13½ Ft.	} Copper	_____ in.	\$ _____	
				C.I.
	C.I.	Pipe at	\$ _____	
Nipples	_____ in.	at	\$ _____	
Bushings	_____ to _____	in. at	\$ _____	
Red'g	} Coupl'gs	_____ to _____	in. at	
Inc'g				
Union	_____ in.	at	\$ _____	
Meter	_____ in.	at	\$ _____	
Lead Joints	_____	at	\$ _____	
Compound Joints	_____	at	\$ _____	
Maintenance Foreman	_____	at	\$ _____	
Hrs. Water Maint. Man—1	_____	at	\$ _____	
Hrs. Water Maint. Man—2	_____	at	\$ _____	
Hrs. Garage Foreman	_____	at	\$ _____	
Hrs. Labor—	_____	at	\$ _____	
Hrs. Compressor	_____	at	\$ _____	
Compensation Ins. at \$	_____	per C	\$ _____	
Trucking	_____		\$ _____	
Pav't Patch	_____		\$ _____	
			\$ _____	
			\$ _____	
O'head	_____		\$ _____	
			\$ _____	

St. Pl. Ave. No. 152

Name of Owner _____
TAX ID # 302.16-6-1

Labor and Mat'l. Report 6-18 1985

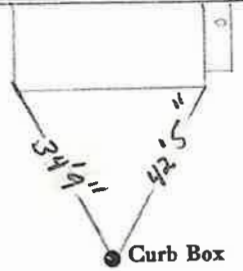

Main Elev. of Main at top _____

Gate at ● ● Gate at _____

13½ to main

● Curb Box

Tap on Sanford
Old Tap shut off