

LABOR AND MATERIALS

1	Copper	} Connection $\frac{3}{4}$	\$	
	Lead			
1	Curb	} Cock Valve } $\frac{3}{4}$ in.	\$	
			T.S. & V.	
1	Service box	} Short $3\frac{1}{2} \times 4\frac{1}{2}$	\$	
	Old returned			Long $4\frac{1}{2} \times 5\frac{1}{2}$
				Buff or Rdway
11	Ft. $\frac{3}{4}$ in.	} Copper } Pipe at	\$	
			C.I.	
	Nipples	in. at	\$	
	Bushings	to in. at	\$	
	Red'g	} Coupl'gs to in. at	\$	
	Inc'g			
	Union	in. at	\$	
	Meter	in. at	\$	
	Lead Joints	at	\$	
	Compound Joints	at	\$	
	Maintenance Foreman		\$	
	Hrs. Water Maint. Man-1	at	\$	
	Hrs. Water Maint. Man-2	at	\$	
	Hrs. Garage Foreman	at	\$	
	Hrs. Labor	at	\$	
	Hrs. Compressor	at	\$	
	Compensation Ins. at \$	per C	\$	
	Trucking		\$	
	Pav't Patch		\$	
			\$	
			\$	
	O'head		\$	
			\$	


St. Pl. Ave. No. 155

BAY

Name of Owner _____

TAX ID #302.16-7-9

Labor and Mat'l. Report 19

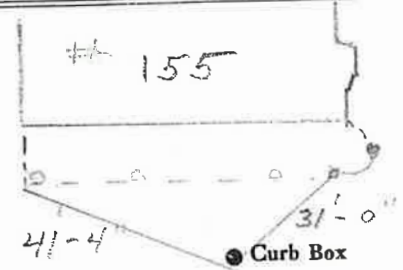

6 " Main Elev. of Main at tap 5

Gate at • • Gate at

• Curb Box