

LABOR AND MATERIALS


1 Copper } Connection <sup>3/4</sup> \$ \_\_\_\_\_  
 Lead }  
 1 Curb } Cock } 3/4 in. \$ \_\_\_\_\_  
 } Valve }  
 } T.S. & V. }  
 1 Service box } Short 3 1/2 x 4 1/2 }  
 Old returned } Long 4 1/2 x 5 1/2 } \$ \_\_\_\_\_  
 } Buff or Rdway }  
 34 Ft. 3/4 in. } Copper } Pipe at \$ \_\_\_\_\_  
 } G.I. }  
 } G.I. }  
 Nipples in. at \$ \_\_\_\_\_  
 Bushings to in. at \$ \_\_\_\_\_  
 Red'g }  
 Inc'g } Coupl'gs to in. at \$ \_\_\_\_\_  
 Union in. at \$ \_\_\_\_\_  
 Meter in. at \$ \_\_\_\_\_  
 Lead Joints at \$ \_\_\_\_\_  
 Compound Joints at \$ \_\_\_\_\_  
 Maintenance Foreman \$ \_\_\_\_\_  
 Hrs. Water Maint. Man—1 at \$ \_\_\_\_\_  
 Hrs. Water Maint. Man—2 at \$ \_\_\_\_\_  
 Hrs. Garage Foreman at \$ \_\_\_\_\_  
 Hrs. Labor— at \$ \_\_\_\_\_  
 Hrs. Compressor at \$ \_\_\_\_\_  
 Compensation Ins. at \$ \_\_\_\_\_ per C \$ \_\_\_\_\_  
 Trucking \$ \_\_\_\_\_  
 Pav't Patch \$ \_\_\_\_\_  
 \$ \_\_\_\_\_  
 \$ \_\_\_\_\_  
 \$ \_\_\_\_\_  
 \$ \_\_\_\_\_  
 O'head \$ \_\_\_\_\_  
 \$ \_\_\_\_\_

St.  
 Pt.  
 Ave. No. 158

BAY

Name of Owner  
 TAX ID # 302.16-6-4

Labor and Mat'l. Report 19

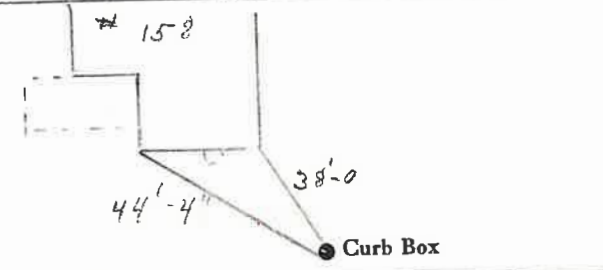

Main Elev. of Main at tap  
 Gate at • Gate at •  
 Curb Box