


LABOR AND MATERIALS

1	Copper Lead	} Connection	3/4	\$		
1	Curb			} Cock Valve T.S. & V.	3/4 in.	\$
1	Service box Old returned	} Short 3 1/2 x 4 1/2 Long 4 1/2 x 5 1/2 Buff or Rdway.				\$
34	Ft. 3/4 in.			} Copper C.I. C.I.	} Pipe at	\$
	Nipples					in. at
	Bushings	to in. at	\$			
	Red'g } Inc'g }	Coupl'gs	to in. at	\$		
	Union	in. at	\$			
	Meter	in. at	\$			
	Lead Joints	at	\$			
	Compound Joints	at	\$			
	Maintenance Foreman		\$			
	Hrs. Water Maint. Man-1	at	\$			
	Hrs. Water Maint. Man-2	at	\$			
	Hrs. Garage Foreman	at	\$			
	Hrs. Labor	at	\$			
	Hrs. Compressor	at	\$			
	Compensation Ins. at \$	per C	\$			
	Trucking		\$			
	Pav't Patch		\$			
	O'head		\$			

BAY St. Pt. Ave. No. 160

Name of Owner
TAX ID # 302.16-6-5

Labor and Mat'l. Report 19

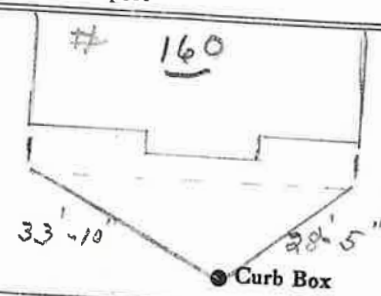

6" Main Elev. of Main at tap 6
Gate at ● Gate at ●

● Curb Box