

### LABOR AND MATERIALS

1	Copper Lead	Connection	$\frac{3}{4}$		\$
1	Curb	Cock Valve T. S. & V.	$\frac{3}{4}$ in.		\$
1	Service box Old returned	Short $3\frac{1}{2} \times 4\frac{1}{2}$ Long $4\frac{1}{2} \times 5\frac{1}{2}$ Buff or Rdway			\$
27	Ft.	Copper G.I. G.I.	$\frac{3}{4}$ in.	Pipe at	\$
	Nipples	in.		at	\$
	Bushings	to		in. at	\$
	Red'g Inc'g	Coupl'gs	to	in. at	\$
	Union	in.		at	\$
	Meter	in.		at	\$
	Lead Joints			at	\$
	Compound Joints			at	\$
	Maintenance Foreman			at	\$
	Hrs. Water Maint. Man	—1		at	\$
	Hrs. Water Maint. Man	—2		at	\$
	Hrs. Garage Foreman			at	\$
	Hrs. Labor			at	\$
	Hrs. Compressor			at	\$
	Compensation Ins.	at \$		per C	\$
	Trucking				\$
	Pav't Patch				\$
	O'head				\$

BAY


St.  
Pl.  
Ave. No. 161

Name of Owner

TAX ID # 302.16-7-6

Labor and Mat'l. Report

19

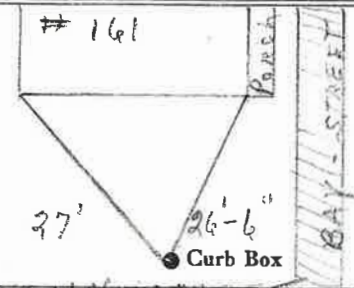

6" Main

Elev. of  
Main at tap 6'

Gate at ● ● Gate at

27' to main

● Curb Box