


LABOR AND MATERIALS

1 Copper } Connection  $\frac{3}{4}$  \$ \_\_\_\_\_  
 1 Lead }  
 1 Curb } Cock }  
 } Valve } in.  $\frac{3}{4}$  \$ \_\_\_\_\_  
 } T.S. & V. }  
 1 Service box { Short  $3\frac{1}{2} \times 4\frac{1}{2}$  }  
 Old returned { Long  $4\frac{1}{2} \times 5\frac{1}{2}$  } \$ \_\_\_\_\_  
 { Buff or Rdway }  
 32 Ft.  $\frac{3}{4}$  in. { Copper } Pipe at \$ \_\_\_\_\_  
 { C.I. }  
 Nipples in. at \$ \_\_\_\_\_  
 Bushings to in. at \$ \_\_\_\_\_  
 Red'g }  
 Inc'g } Coupl'gs to in. at \$ \_\_\_\_\_  
 Union in. at \$ \_\_\_\_\_  
 Meter in. at \$ \_\_\_\_\_  
 Lead Joints at \$ \_\_\_\_\_  
 Compound Joints at \$ \_\_\_\_\_  
 Maintenance Foreman \$ \_\_\_\_\_  
 Hrs. Water Maint. Man-1 at \$ \_\_\_\_\_  
 Hrs. Water Maint. Man-2 at \$ \_\_\_\_\_  
 Hrs. Garage Foreman at \$ \_\_\_\_\_  
 Hrs. Labor- at \$ \_\_\_\_\_  
 Hrs. Compressor at \$ \_\_\_\_\_  
 Compensation Ins. at \$ \_\_\_\_\_ per C \$ \_\_\_\_\_  
 Trucking \$ \_\_\_\_\_  
 Pav't Patch \$ \_\_\_\_\_  
 \$ \_\_\_\_\_  
 \$ \_\_\_\_\_  
 \$ \_\_\_\_\_  
 O'head \$ \_\_\_\_\_  
 \$ \_\_\_\_\_

BAY St. \_\_\_\_\_  
 Ave. No. 162  
 Name of Owner \_\_\_\_\_  
 TAX ID # 302.16-6-6

Labor and Mat'l. Report 19

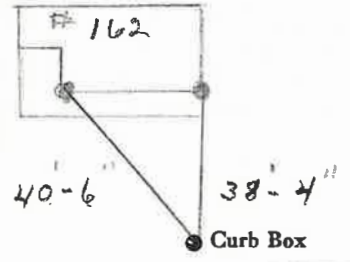

6 Main Elev. of Main at tap  $5\frac{1}{2}$   
 Gate at • Gate at •  
 • Curb Box