

### LABOR AND MATERIALS

Copper	}	Connection	_____	\$	_____
Lead					
Curb	}	Cock	_____ in.	\$	_____
		Valve			
		T. S. & V.			
Service box	}	Short 3½ x 4½	_____	\$	_____
Old returned		Long 4½ x 5½			
		Buff or Rdway			
11½ Ft.	}	Copper	_____	\$	_____
3/4 in.		G.I.			
Nipples		in. at	_____	\$	_____
Bushings		to _____ in. at	_____	\$	_____
Red'g	}	Coupl'gs	to _____ in. at	\$	_____
Inc'g					
Union		in. at	_____	\$	_____
Meter		in. at	_____	\$	_____
Lead Joints		at	_____	\$	_____
Compound Joints		at	_____	\$	_____
Maintenance Foreman			_____	\$	_____
Hrs. Water Maint. Man-1		at	_____	\$	_____
Hrs. Water Maint. Man-2		at	_____	\$	_____
Hrs. Garage Foreman		at	_____	\$	_____
Hrs. Labor		at	_____	\$	_____
Hrs. Compressor		at	_____	\$	_____
Compensation Ins. at \$		per C	_____	\$	_____
Trucking			_____	\$	_____
Pav't Patch			_____	\$	_____
			_____	\$	_____
			_____	\$	_____
			_____	\$	_____
O'head			_____	\$	_____
			_____	\$	_____


St.  
Pl.  
Ave. No. 167

Name of Owner \_\_\_\_\_

TAX ID # 302.12-26-10

Labor and Mat'l. Report

19

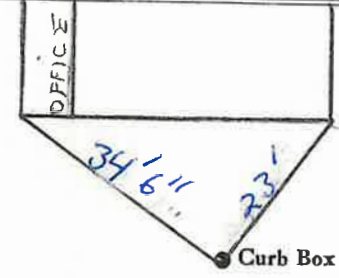

	Elev. of
Main	Main at tap
Gate at ●	● Gate at

● Curb Box