


LABOR AND MATERIALS

1	Copper	} Connection $\frac{3}{4}$	ORISEAL	\$
1	Lead			
1	Curb	} Cock Valve } $\frac{3}{4}$ in.		\$
			T.S. & V.	
1	Service box	} { Short $3\frac{1}{2}$ x $4\frac{1}{2}$ Long $4\frac{1}{2}$ x $5\frac{1}{2}$ Buff or Rdway }		\$
	Old returned			\$
15	Ft. $\frac{3}{4}$ in.		} { Copper G.I. C.I. }	Pipe at
				\$
	Nipples	in. at		\$
	Bushings	to in. at		\$
	Red'g } Inc'g }	Coupl'gs to in. at		\$
	Union	in. at		\$
	Meter	in. at		\$
	Lead Joints	at		\$
	Compound Joints	at		\$
	Maintenance Foreman			\$
	Hrs. Water Maint. Man-1	at		\$
	Hrs. Water Maint. Man-2	at		\$
	Hrs. Garage Foreman	at		\$
	Hrs. Labor	at		\$
	Hrs. Compressor	at		\$
	Compensation Ins.	at \$ per C		\$
	Trucking			\$
	Pav't Patch			\$
				\$
				\$
	O'head			\$
				\$

BAY St. Pt. Ave. No. 169

Name of Owner
TAX ID # 302.12-26-9

Labor and Mat'l. Report 19

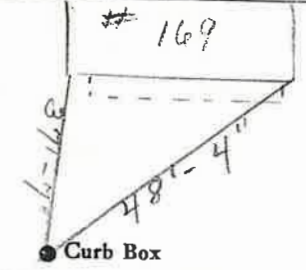

6" Main Elev. of Main at tap $5\frac{1}{2}$
Gate at • Gate at

• Curb Box