


LABOR AND MATERIALS

Copper	} Connection	_____	\$ _____
Lead			
Curb	} Cock Valve T. S. & V.	_____ in.	\$ _____
Service box		{ Short 3½ x 4½ Long 4½ x 5½ }	_____
Old returned			_____ \$ _____
36 Ft.	{ Copper G.I. C.I.	3/4 in. } Pipe at _____	\$ _____
Nipples		in. at _____	\$ _____
Bushings	to _____ in.	at _____	\$ _____
Red'g Inc'g	} Coupl'gs	to _____ in.	at _____ \$ _____
Union		in. at _____	\$ _____
Meter	in. at _____	\$ _____	
Compound Joints	at _____	\$ _____	
Maintenance Foreman	_____	\$ _____	
Hrs. Water Maint. Man-1	at _____	\$ _____	
Hrs. Water Maint. Man-2	at _____	\$ _____	
Hrs. Garage Foreman	at _____	\$ _____	
Hrs. Labor	at _____	\$ _____	
Hrs. Compressor	at _____	\$ _____	
Trucking	_____	\$ _____	
Pav't Patch	_____	\$ _____	
		\$ _____	
		\$ _____	
St. _____
Pl. _____
Ave. No. 38

Name of Owner
Harry Clute

Labor and Mat'l. Report 10/20/77

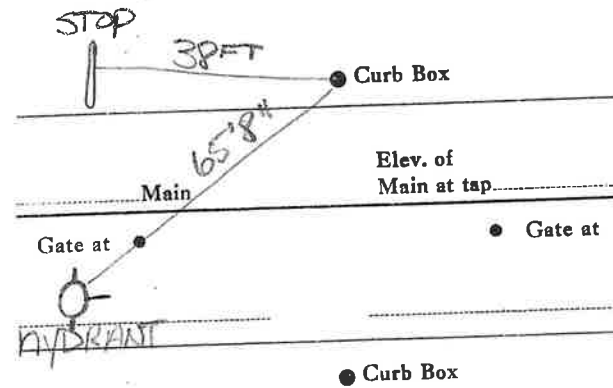

TAP IS ON FAXON