

LABOR AND MATERIALS

<del>3/4</del> Copper } Connection _____	\$ _____
<del>Lead</del> } _____	
Curb } Cock _____ in.	\$ _____
} Valve _____	
} T. S. & V. _____	
Service box } Short 3 1/2 x 4 1/2 } _____	
Old returned } Long 4 1/2 x 5 1/2 } _____	\$ _____
25' 3/4 in. } Copper } Pipe at _____	\$ _____
} G.I. } _____	
} G.I. } _____	
Nipples _____ in. at _____	\$ _____
Bushings _____ to _____ in. at _____	\$ _____
Red'g } Coupl'gs _____ to _____ in. at _____	\$ _____
Inc'g } _____	
Union _____ in. at _____	\$ _____
Meter _____ in. at _____	\$ _____
_____	\$ _____
Compound Joints at _____	\$ _____
Maintenance Foreman _____	\$ _____
Hrs. Water Maint. Man—1 at _____	\$ _____
Hrs. Water Maint. Man—2 at _____	\$ _____
Hrs. Garage Foreman _____ at _____	\$ _____
Hrs. Labor— _____ at _____	\$ _____
Hrs. Compressor at _____	\$ _____
_____	\$ _____
Trucking _____	\$ _____
Pav't Patch _____	\$ _____
_____	\$ _____
_____	\$ _____
_____	\$ _____
_____	\$ _____

E BEACON


St. Pl. Ave. No. 30

Name of Owner

Harry Clute

Labor and Mat'l. Report

10/28/1977

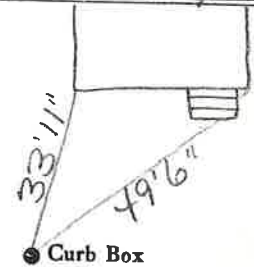

Main \_\_\_\_\_ Elev. of Main at tap \_\_\_\_\_  
 Gate at ● \_\_\_\_\_ ● Gate at \_\_\_\_\_

● Curb Box