

LABOR AND MATERIALS

Copper	}	Connection		\$	
Lead					
Curb	}	Cock			
		Valve	in.	\$	
		T. S. & V.			
Service box	}	Short 3½ x 4½			
Old returned		Long 4½ x 5½			
			\$		
Ft. <u>3/4</u> in.	}	Copper	} Pipe at	\$	
		G. I.			
		G. I.			
Nipples	in.	at		\$	
Bushings	to	in.	at		\$
Red'g	}	Coupl'gs	to	in.	at
Inc'g					
Union	in.	at		\$	
Meter	in.	at		\$	
				\$	
Compound Joints	at			\$	
Maintenance Foreman	at			\$	
Hrs. Water Maint. Man—1	at			\$	
Hrs. Water Maint. Man—2	at			\$	
Hrs. Garage Foreman	at			\$	
Hrs. Labor—	at			\$	
Hrs. Compressor	at			\$	
				\$	
Trucking				\$	
Pav't Patch				\$	
				\$	
				\$	
				\$	
				\$	


E. BEACON

St. Pt. Ave. No. 31

Name of Owner

Labor and Mat'l. Report

1989

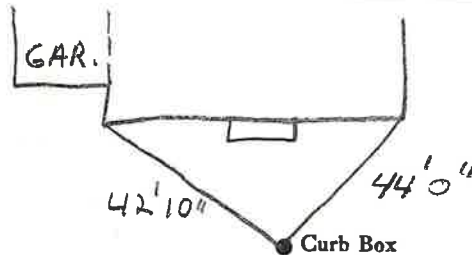

	Elev. of
Main	Main at tap
Gate at ●	● Gate at

● Curb Box