

LABOR AND MATERIALS

| | | | | | | | | |
|-----|-------------------------|--|-----------------|-------|-------|--|--|--|
| 20' | Copper | Connection | _____ | \$ | _____ | | | |
| | Lead | | | | | | | |
| 34" | Curb | Cock Valve T.S. & V. | } _____ in. | \$ | _____ | | | |
| | | | | | | | | |
| | | | | | | | | |
| | Service box | } Short 3½ x 4½ Long 4½ x 5½ | } _____ | \$ | _____ | | | |
| | Old returned | | | | | | | |
| 20' | Pt. 3/4 in. | } Copper G.I. G.I. | } Pipe at _____ | \$ | _____ | | | |
| | | | | | | | | |
| | | | | | | | | |
| | Nipples | in. at _____ | \$ | _____ | | | | |
| | Bushings | to _____ in. at _____ | \$ | _____ | | | | |
| | Red'g Inc'g | } Coupl'gs _____ to _____ in. at _____ | \$ | _____ | | | | |
| | | | | | | | | |
| | Union | in. at _____ | \$ | _____ | | | | |
| | Meter | in. at _____ | \$ | _____ | | | | |
| | | | \$ | _____ | | | | |
| | Compound Joints | at _____ | \$ | _____ | | | | |
| | Maintenance Foreman | | \$ | _____ | | | | |
| | Hrs. Water Maint. Man-1 | at _____ | \$ | _____ | | | | |
| | Hrs. Water Maint. Man-2 | at _____ | \$ | _____ | | | | |
| | Hrs. Garage Foreman | at _____ | \$ | _____ | | | | |
| | Hrs. Labor | at _____ | \$ | _____ | | | | |
| | Hrs. Compressor | at _____ | \$ | _____ | | | | |
| | | | \$ | _____ | | | | |
| | Trucking | | \$ | _____ | | | | |
| | Pav't Patch | | \$ | _____ | | | | |
| | | | \$ | _____ | | | | |
| | | | \$ | _____ | | | | |
| | | | \$ | _____ | | | | |
| | | | \$ | _____ | | | | |

#32, or. House


E. BEACON

St. 32
Pl. _____
Ave. No. 34

Name of Owner _____

Labor and Mat'l. Report _____

Apr. 19 97

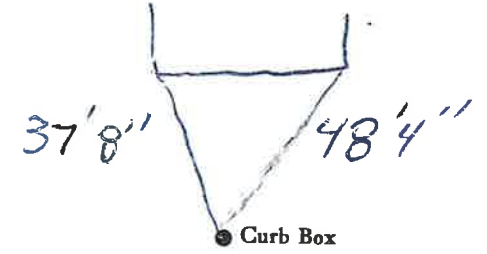

6" Main

Elev. of
Main at tap 5½'

Gate at ●

● Gate at

● Curb Box