




### LABOR AND MATERIALS

3/4 Copper } Connection \_\_\_\_\_ \$  
 Curb } Cock Valve } \_\_\_\_\_ in. \$  
       } T.S. & V. }  
 Service box { Short 3-1/2 x 4-1/2 } \_\_\_\_\_ \$  
 Old returned { Long 4-1/2 x 5-1/2 }  
 3 Ft. 6 in. { Copper } Pipe at \_\_\_\_\_ \$  
               } G.I. }  
               } C.I. }  
 Nipples \_\_\_\_\_ in. at \_\_\_\_\_ \$  
 Bushings \_\_\_\_\_ to \_\_\_\_\_ in. at \_\_\_\_\_ \$  
 Red'g \_\_\_\_\_  
 Inc'g \_\_\_\_\_  
 Union \_\_\_\_\_ in. at \_\_\_\_\_ \$  
 Meter \_\_\_\_\_ in. at \_\_\_\_\_ \$  
 \_\_\_\_\_ \$  
 Compound Joints at \_\_\_\_\_ \$  
 Maintenance Foreman \_\_\_\_\_ \$  
 Hrs. Water Maint. Man - 1 at \_\_\_\_\_ \$  
 Hrs. Water Maint. Man - 2 at \_\_\_\_\_ \$  
 Hrs. Garage Foreman \_\_\_\_\_ at \_\_\_\_\_ \$  
 Hrs. Labor \_\_\_\_\_ at \_\_\_\_\_ \$  
 Hrs. Compressor at \_\_\_\_\_ \$  
 \_\_\_\_\_ \$  
 Trucking \_\_\_\_\_ \$  
 Pav't Patch \_\_\_\_\_ \$  
 \_\_\_\_\_ \$  
 \_\_\_\_\_ \$  
EAST BEACON St. Ave. No. 42  
 Name of Owner

TAP ON FAXON

Labor and Mat'l. Report # 2006

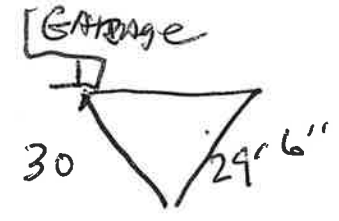

6 Main Elev. of Main at tap 3'9"

Gate at • Gate at •

3'6" to main

• Curb Box

4" sewer E BEACON