

LABOR AND MATERIALS

1.	Copper Lead	Connection	1" X 3/4" Tee	\$	44
1.	Curb	Cock Valve T. S. & V.	3/4" in.	\$	3.71
1.	Service box Old returned	Short 3 1/2 X 4 1/2 Long 4 1/2 X 5 1/2 Buffer Rdway		\$	5.90
7.	Ft. 3/4 in.	Copper G. I. C. I.	Pipe at 30	\$	2.10
	Nipples	in. at		\$	
	Bushings	to in. at		\$	
	Red'g Inc'g	Coupl'gs to in. at		\$	
	Union	in. at		\$	
	Meter	in. at		\$	
	Lead Joints	at		\$	
	Compound Joints	at		\$	
	Hrs. Water Maint. Man-1	at		\$	
1.	Hrs. Water Maint. Man-2	at 1.02		\$	1.02
8.	Hrs. Labor-	at 91		\$	7.28
	Hrs. Labor-	at		\$	
	Hrs. Compressor	at		\$	
	Compensation Ins. at \$	per C	18	\$	
	Trucking		1.00	\$	
	Pav't Patch			\$	
	<i>Tap by McGowan</i>				
	O'head			\$	
				\$	21.63

145

East

Barren

44
487


St. _____
Pl. _____
Ave. No. 3

Name of Owner

Murray

Labor and Mat'l. Report

Oct 21 19 10

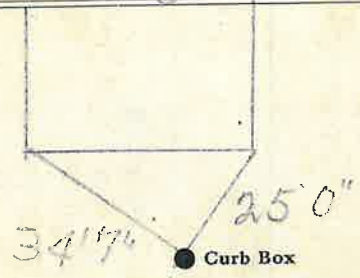

14 Copper

Main _____ Elev. of Main at tap 5

Gate at ● _____ ● Gate at _____

● Curb Box

