

LABOR AND MATERIALS

_____	Copper	} Connection	_____	\$	_____
_____	Lead		_____	\$	_____
_____	Curb	} Cock Valve T.S. & V.	_____ in.	\$	_____
_____	Service box		{ Short 3-1/2 x 4-1/2 Long 4-1/2 x 5-1/2 }	_____	\$
_____	Old returned	_____		\$	_____
5 17	Ft. 3/4 ^{3/4} in.	{ Copper G.I. P.L.P. 351C }	Pipe at	\$	_____
_____	Nipples		_____ in. at	\$	_____
_____	Bushings	_____ to _____ in. at	\$	_____	
_____	Red'g				_____
_____	Inc'g				_____
_____	Union	_____ in. at	\$	_____	
_____	Meter	_____ in. at	\$	_____	
_____			\$	_____	
_____	Compound Joints at		\$	_____	
_____	Maintenance Foreman		\$	_____	
_____	Hrs. Water Maint. Man - 1 at		\$	_____	
_____	Hrs. Water Maint. Man - 2 at		\$	_____	
_____	Hrs. Garage Foreman	_____ at	\$	_____	
_____	Hrs. Labor	_____ at	\$	_____	
_____	Hrs. Compressor at		\$	_____	
_____			\$	_____	
_____	Trucking		\$	_____	
_____	Pav't Patch		\$	_____	
_____			\$	_____	
_____			\$	_____	
_____			\$	_____	
_____			\$	_____	


E. BEACON

'St. Pl. Ave. No. 46

Name of Owner

Labor and Mat'l. Report 19

4-29-2014

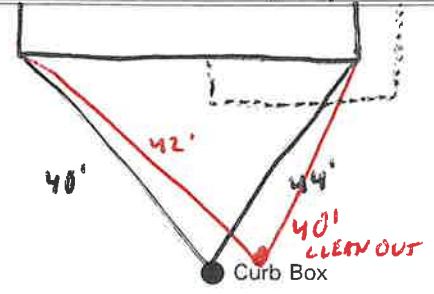

6" Main

Elev. of Main at tap 6

Gate at ●

● Gate at

● Curb Box


New 9/5/17
3/4 PLASTIC (17')

LABOR AND MATERIALS

_____	Copper } Connection _____	\$ _____
_____	Lead } _____	\$ _____
_____	Curb } Cock Valve } _____ in.	\$ _____
	} T.S. & V. }	
_____	Service box { Short 3-1/2 x 4-1/2 }	\$ _____
_____	Old returned { Long 4-1/2 x 5-1/2 }	\$ _____
29	Ft. 3/4 in. { Copper } Pipe at _____	\$ _____
	} G.I. }	
	} C.I. }	
_____	Nipples _____ in. at _____	\$ _____
_____	Bushings _____ to _____ in. at _____	\$ _____
_____	Red'g _____	\$ _____
_____	Inc'g _____	\$ _____
_____	Union _____ in. at _____	\$ _____
_____	Meter _____ in. at _____	\$ _____
_____	_____	\$ _____
_____	Compound Joints at _____	\$ _____
_____	Maintenance Foreman _____	\$ _____
_____	Hrs. Water Maint. Man - 1 at _____	\$ _____
_____	Hrs. Water Maint. Man - 2 at _____	\$ _____
_____	Hrs. Garage Foreman _____ at _____	\$ _____
_____	Hrs. Labor _____ at _____	\$ _____
_____	Hrs. Compressor at _____	\$ _____
_____	_____	\$ _____
_____	Trucking _____	\$ _____
_____	Pav't Patch _____	\$ _____
_____	_____	\$ _____
_____	_____	\$ _____
East Beacon 46
 Name of Owner PI. Ave. No. ~~43B~~

Labor and Mat'l. Report **Dec. 10, 2007**

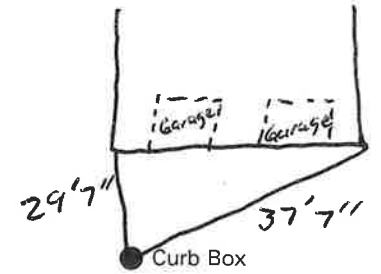

1" Main Elev. of Main at tap _____
 Gate at ● ● Gate at

● Curb Box
 21' of 4" sewer lateral to main from curb box.
 3/4" water service is TIE'ID into 1" water line that feeds from Faxon st. Curb stop for 1" line is on the corner of Faxon st. and E. Beacon st.