

LABOR AND MATERIALS

~~Copper~~ Connection 1" Curb stop \$ 4.28
~~Lead~~ }
 Curb { Cock Valve } in. \$
 T. S. & V. }
 Service box { Short 3/4 X 4 1/2 }
 Old returned { Long 4 1/2 X 5 1/2 } \$ 4.74
 Buff or Rdway }
~~3/4~~ 3/4 in. Copper Pipe at 38 \$ 11.02
 17 3/4 in. G.I. 2017 TM
 Nipples in. at \$
 Bushings 1" to 3/4 in. at \$.60
 Red'g }
 Inc'g Coupl'gs to in. at \$
 Union in. at \$
 Meter in. at \$
 Lead Joints at \$
 Compound Joints at \$
 2 Hrs. Water Maint. Man-1 at \$ 3.18
 6 Hrs. Water Maint. Man-2 at 1.24 \$ 7.44
 16 Hrs. Labor- at 1.13 \$ 18.08
 Hrs. Labor- at \$
 Hrs. Compressor at \$
 Compensation Ins. at \$4.06 per C \$ 1.26
 Trucking \$ 1.00
 Pav't Patch \$
 1- 1" Cap. to Cap. Mueller Tee \$.73
 2- 3/4" Male adapter \$ 1.06
 2- 1" N-Cap. 47 \$.94
 O'head \$
 Top time 8-53
 by Gifford \$ 54.33


new rate

41-53
East

Beacon St.
Pl. Ave. No. 49

Name of Owner
Richardson

Labor and Mat'l. Report ~~June 8~~ 1953

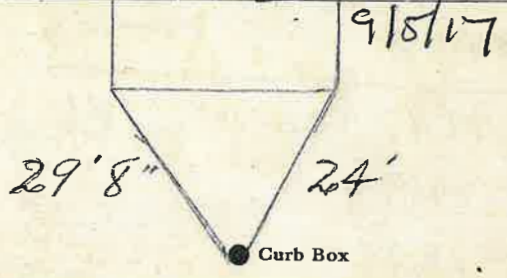

6" Main Elev. of Main at tap 5'

Gate at ● Gate at ●

TAX ID # 309.16-15-1

