

LABOR AND MATERIALS

|                               |                       |            |          |
|-------------------------------|-----------------------|------------|----------|
| 3/4" Copper                   | Connection            | 3/4"       | \$ 2.87  |
| Lead                          |                       |            |          |
| 1. Curb                       | Cock Valve T. S. & V. | 3/4" in.   | \$ 2.62  |
| 1. Service box                | Short 3 1/2 X 4 1/2   |            |          |
| Old returned                  | Long 4 1/2 X 5 1/2    |            |          |
|                               | Buff or Rdway         |            | \$ 4.68  |
| 26' Ft. 3/4" in.              | Copper                | Pipe at 32 | \$ 3.84  |
| PLASTIC                       | G. I.                 |            |          |
|                               | C. I.                 | 2017       |          |
| Nipples                       | in. at                |            | \$       |
| 1. Bushings                   | 1" to 3/4" in. at     |            | \$ 63    |
| Red'g                         |                       |            |          |
| Inc'g                         | Coupl'gs to in. at    |            | \$       |
| Union                         | in. at                |            | \$       |
| 1. Meter                      | 3/4" in. at           |            | \$ 3.5   |
| Lead Joints at                |                       |            | \$       |
| Compound Joints at            |                       |            | \$       |
| Hrs. Water Maint. Man-1 at    |                       |            | \$       |
| 4. Hrs. Water Maint. Man-2 at | 1.02                  |            | \$ 4.08  |
| 1.7 Hrs. Labor-               | at                    | 91         | \$ 10.92 |
| Hrs. Labor-                   | at                    |            | \$       |
| Hrs. Compressor at            |                       |            | \$       |
| Compensation Ins. at          | \$ 2.18 per C         |            | \$ 33    |
| Trucking                      |                       |            | \$ 2.80  |
| Pav't Patch                   |                       |            | \$       |
| O'head                        |                       |            | \$       |

NEW TAP 2017 \$33.32


1  
East

Beacon

St. 50  
Pl. X  
Ave. No.

Name of Owner Roy Krebs

Labor and Mat'l. Report 9/5/17 19

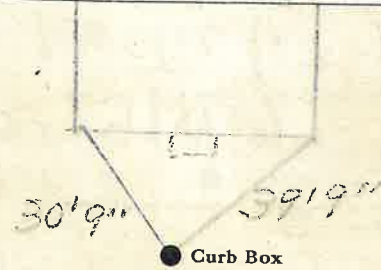

6" Main

Elev. of Main at tap 5

Gate at ●

● Gate at

● Curb Box

NEW MAIN AND TAP 26' PLASTIC 6" MAIN