


### LABOR AND MATERIALS

1	Copper } Connection	<u>3/4</u>				\$	
	Lead } Cock						
1	Curb } Valve	<u>3/4</u> in.				\$	
		T.S. & V.					
1	Service box } Short 3 1/2 x 4 1/2						
	Old returned } Long 4 1/2 x 5 1/2						
		Buff or Rdway				\$	
32	Ft. <u>3/4</u> in.	Copper } Pipe at				\$	
		G.I.					
		G.I.					
	Nipples	in. at				\$	
	Bushings	to in. at				\$	
	Red'g } Coupl'gs	to in. at				\$	
	Inc'g }						
	Union	in. at				\$	
	Meter	in. at				\$	
	Lead Joints	at				\$	
	Compound Joints	at				\$	
	Maintenance Foreman					\$	
	Hrs. Water Maint. Man-1	at				\$	
	Hrs. Water Maint. Man-2	at				\$	
	Hrs. Garage Foreman	at				\$	
	Hrs. Labor	at				\$	
	Hrs. Compressor	at				\$	
	Compensation Ins. at \$	per C				\$	
	Trucking					\$	
	Pav't Patch					\$	
						\$	
						\$	
	O'head					\$	
						\$	

St. Pt. 4  
Ave. No. 4

West  
BEACON  
Name of Owner

Labor and Mat'l. Report 19

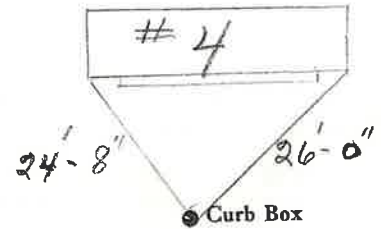

6\" Main Elev. of Main at tap 3 1/2

Gate at ● ● Gate at

● Curb Box