


LABOR AND MATERIALS

1	Copper	} Connection	3/4"	\$
	Lead			
1	Curb	} Cock Valve T.S. & V.	3/4" in.	\$
1	Service box	} Short 3 1/2 x 4 1/2 Long 4 1/2 x 5 1/2 Buff or Rdway	4' x 5'	\$
	Old returned			
29	Ft.	} Copper G.I. C.I.	3/4" in.	\$
	Nipples	in. at		\$
	Bushings	to in. at		\$
	Red'g	} Coupl'gs	to in. at	\$
	Inc'g			
	Union	in. at		\$
	Meter	in. at		\$
	Lead Joints	at		\$
	Compound Joints	at		\$
	Maintenance Foreman			\$
	Hrs. Water Maint. Man-1	at		\$
	Hrs. Water Maint. Man-2	at		\$
	Hrs. Garage Foreman	at		\$
	Hrs. Labor	at		\$
	Hrs. Compressor	at		\$
	Compensation Ins. at \$	per C.		\$
	Trucking			\$
	Pav't Patch			\$
	Tap by Lapeau & Co			\$
	7-12-71			\$
	O'head			\$

West Beacon St. Pt. Ave. No. 5

Name of Owner D. Carpenter

Labor and Mat'l. Report July 12 1971

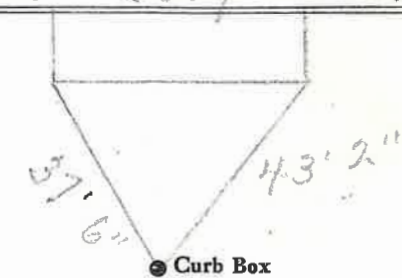

6" Main Elev. of Main at tap 5"

Gate at • Gate at •

TAX ID # 309.16-10-15

• Curb Box