

LABOR AND MATERIALS

Copper	} Connection	_____	\$ _____	
Lead				
Curb	} Cock	_____ in.	\$ _____	
				} Valve
Service box	{ Short 3½ x 4½ }	_____	\$ _____	
Old returned		{ Long 4½ x 5½ }	_____	\$ _____
Ft. 3/4 in.	} Copper	} Pipe at	\$ _____	
			} G. I.	
				} G. I.
Nipples	_____ in. at	\$ _____		
Bushings	_____ to _____ in. at	\$ _____		
Red'g	} Coupl'gs	_____ to _____ in. at	\$ _____	
Inc'g				
Union	_____ in. at	\$ _____		
Meter	_____ in. at	\$ _____		
		\$ _____		
Compound Joints	at	\$ _____		
Maintenance Foreman		\$ _____		
Hrs. Water Maint. Man—1	at	\$ _____		
Hrs. Water Maint. Man—2	at	\$ _____		
Hrs. Garage Foreman	at	\$ _____		
Hrs. Labor—	at	\$ _____		
Hrs. Compressor	at	\$ _____		
		\$ _____		
Trucking		\$ _____		
Pav't Patch		\$ _____		
		\$ _____		
		\$ _____		
		\$ _____		
		\$ _____		


W. BEACON

St. ~~Pl.~~  
Ave. No. 6

Name of Owner

Labor and Mat'l. Report

19 94

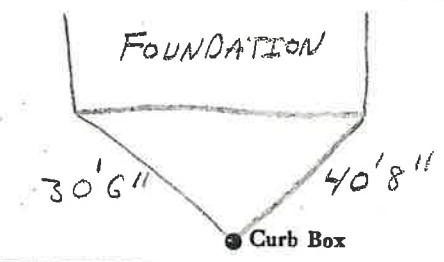

Main

Elev. of Main at tap

Gate at ●

● Gate at

● Curb Box