


LABOR AND MATERIALS

| | | | | | | |
|-----|----------------------------|------------|---------------------|---------|----|--|
| / | Copper | } | Connection | | \$ | |
| | Lead | | | | | |
| / | Curb | } | Cock Valve | in. | \$ | |
| | | | T.S. & V. | | | |
| / | Service box | } | Short 3 1/2 x 4 1/2 | | | |
| | Old returned | | Long 4 1/2 x 5 1/2 | | | |
| | | | Buff or Rdway | | \$ | |
| 28' | Ft. 3/4 in. | } | Copper | Pipe at | \$ | |
| | | | C.I. | | | |
| | | | C.I. | | | |
| | Nipples | in. at | | | \$ | |
| | Bushings | to in. at | | | \$ | |
| | Red'g | } Coupl'gs | to in. at | | \$ | |
| | Inc'g | | | | | |
| | Union | in. at | | | \$ | |
| | Meter | in. at | | | \$ | |
| | Lead Joints at | | | | \$ | |
| | Compound Joints at | | | | \$ | |
| | Maintenance Foreman | | | | \$ | |
| | Hrs. Water Maint. Man—1 at | | | | \$ | |
| | Hrs. Water Maint. Man—2 at | | | | \$ | |
| | Hrs. Garage Foreman at | | | | \$ | |
| | Hrs. Labor— at | | | | \$ | |
| | Hrs. Compressor at | | | | \$ | |
| | Compensation Ins. at \$ | per C | | | \$ | |
| | Trucking | | | | \$ | |
| | Pav't Patch | | | | \$ | |
| | | | | | \$ | |
| | | | | | \$ | |
| | | | | | \$ | |
| | O'head | | | | \$ | |
| | | | | | \$ | |

St.
Pl.
WEST BEACON Ave. No. 11

Name of Owner _____

Labor and Mat'l. Report 19

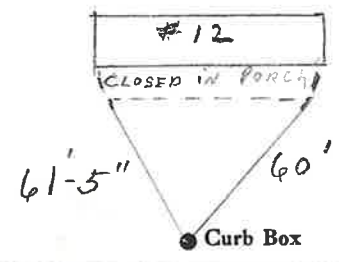

6" Main Elev. of Main at tap 5'

Gate at ● ● Gate at

● Curb Box

THIS TAP FOR #11 WEST BEACON ST.
MEASURED IN FROM #12 WEST BEACON ST.