

LABOR AND MATERIALS

Copper } Connection _____	\$ _____
Lead } _____	
Curb } Cock _____	in. \$ _____
} Valve _____	
} T. S. & V. _____	
Service box { Short 3½ x 4½ } _____	
Old returned { Long 4½ x 5½ } _____	
} Buff or Rdway _____	\$ _____
23 Ft. ¾ in. { Copper } Pipe at _____	\$ _____
} C.I. _____	
} C.I. _____	
Nipples _____ in. at _____	\$ _____
Bushings _____ to _____ in. at _____	\$ _____
Red'g } _____	
Inc'g } Coupl'gs _____ to _____ in. at _____	\$ _____
Union _____ in. at _____	\$ _____
Meter _____ in. at _____	\$ _____
Lead Joints at _____	\$ _____
Compound Joints at _____	\$ _____
Maintenance Foreman _____	\$ _____
Hrs. Water Maint. Man—1 at _____	\$ _____
Hrs. Water Maint. Man—2 at _____	\$ _____
Hrs. Garage Foreman _____ at _____	\$ _____
Hrs. Labor— _____ at _____	\$ _____
Hrs. Compressor at _____	\$ _____
Compensation Ins. at \$ _____ per C _____	\$ _____
Trucking _____	\$ _____
Pav't Patch _____	\$ _____
_____	\$ _____
_____	\$ _____
_____	\$ _____
O'head _____	\$ _____
_____	\$ _____

W. Beacon


St. _____
 Pt. _____
 Ave. No. ~~15~~ 15

Name of Owner

John Deeb

Labor and Mat'l. Report

Nov 19 87

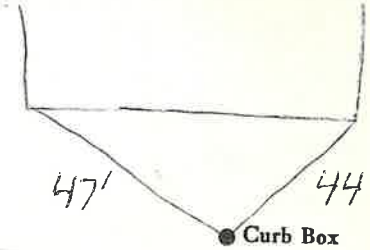

Main

Elev. of
Main at tap

Gate at ●

● Gate at

● Curb Box