

LABOR AND MATERIALS


1	Copper	} Connection	3/4"	\$
	Lead			
1	Curb	} Cock Valve T.S. & V.	3/4 in.	\$
1	Service box	} Short 3 1/2 x 4 1/2 Long 4 1/2 x 5 1/2 Buff or Rdway		\$
	Old returned			
8 1/2	Ft.	} Copper G.I. C.I.	3/4 in.	Pipe at \$
	Nipples	in. at		\$
	Bushings	to in. at		\$
	Red'g	} Coupl'gs	to in. at	\$
	Inc'g			
	Union	in. at		\$
	Meter	in. at		\$
	Lead Joints	at		\$
	Compound Joints	at		\$
	Maintenance Foreman			\$
	Hrs. Water Maint. Man	—1 at		\$
	Hrs. Water Maint. Man	—2 at		\$
	Hrs. Garage Foreman	at		\$
	Hrs. Labor	at		\$
	Hrs. Compressor	at		\$
	Compensation Ins. at \$	per C		\$
	Trucking			\$
	Pav't Patch			\$
				\$
				\$
	O'head			\$
				\$

#16 MAILING ADDRESS

St. 16
~~Pl.~~
 Ave. No. 18

W-BEACON
 Name of Owner

Labor and Mat'l. Report 19

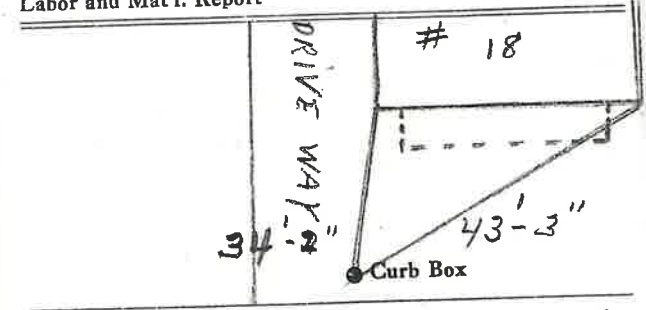

6" Main Elev. of Main at tap 3 1/2'

Gate at ● ● Gate at

● Curb Box