

LABOR AND MATERIALS


1	Copper	} Connection $\frac{3}{4}$	\$	
	Lead			
1	Curb	} $\frac{3}{4}$ in.	\$	
	Cock			
	Valve			
		T.S. & V.		
1	Service box	{ Short $3\frac{1}{2} \times 4\frac{1}{2}$	\$	
	Old returned			{ Long $4\frac{1}{2} \times 5\frac{1}{2}$
				{ Buff or Rdway
42	Pt. $\frac{3}{4}$ in.	{ Copper	\$	
		{ C.I.		
		{ C.I.	\$	
		Pipe at		
	Nipples	in. at	\$	
	Bushings	to in. at	\$	
	Red'g	} Coupl'gs to in. at	\$	
	Inc'g			
	Union	in. at	\$	
	Meter	in. at	\$	
	Lead Joints	at	\$	
	Compound Joints	at	\$	
	Maintenance Foreman		\$	
	Hrs. Water Maint. Man—1	at	\$	
	Hrs. Water Maint. Man—2	at	\$	
	Hrs. Garage Foreman	at	\$	
	Hrs. Labor	at	\$	
	Hrs. Compressor	at	\$	
	Compensation Ins. at \$	per C	\$	
	Trucking		\$	
	Pav't Patch		\$	
			\$	
			\$	
	O'head		\$	
			\$	

St.
Pl.
Ave. No. 19

W. BEACON

Name of Owner

Labor and Mat'l. Report 19

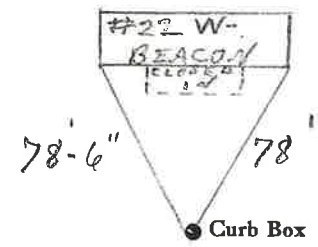

6" C.I. Main Elev. of Main at tap $4\frac{1}{2}$

Gate at • Gate at

This TAP • Curb Box
MEASURED IN FROM
#22 W- BEACON ST.


LABOR AND MATERIALS

Copper } Connection _____	\$ _____
Lead } _____	\$ _____
Curb } Cock Valve } _____ in.	\$ _____
} T. S. & V. }	
Service box { Short 3½ x 4½ }	\$ _____
Old returned { Long 4½ x 5½ }	\$ _____
234" Ft. 3/4 in. { Copper } Pipe at _____	\$ _____
} G. I. }	
} C. I. }	
Nipples _____ in. at _____	\$ _____
Bushings _____ to _____ in. at _____	\$ _____
Red'g } Coupl'gs _____ to _____ in. at _____	\$ _____
Inc'g }	
Union _____ in. at _____	\$ _____
Meter _____ in. at _____	\$ _____
_____	\$ _____
Compound Joints at _____	\$ _____
Maintenance Foreman _____	\$ _____
Hrs. Water Maint. Man—1 at _____	\$ _____
Hrs. Water Maint. Man—2 at _____	\$ _____
Hrs. Garage Foreman _____ at _____	\$ _____
Hrs. Labor— _____ at _____	\$ _____
Hrs. Compressor at _____	\$ _____
_____	\$ _____
Trucking _____	\$ _____
Pav't Patch _____	\$ _____
_____	\$ _____
_____	\$ _____
_____	\$ _____
_____	\$ _____

St. _____
 Pl. _____
 Ave. No. 19


Name of Owner _____

Labor and Mat'l. Report 19 90

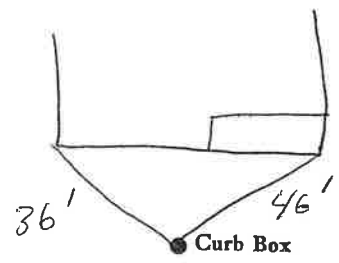

Main	Elev. of Main at tap
Gate at ●	● Gate at
_____	_____
_____	_____
● Curb Box	

5-7-90

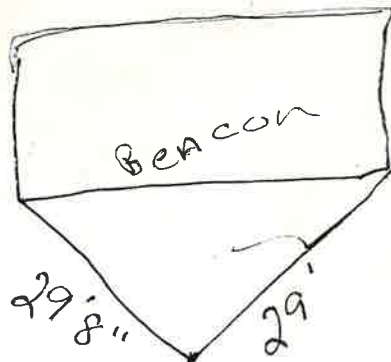

no.?

33 ³/₄ copper

21 ⁴/₄ plastic

sewer

water main

6" 4 ¹/₂ depth