

### LABOR AND MATERIALS

Copper	}	Connection		\$	
Lead					
Curb	}	Cock	in.		
		Valve			
		T. S. & V.			
Service box	}	Short 3½ x 4½			
		Long 4½ x 5½			
Old returned		Buff or Rdway			
Ft.	}	Copper	Pipe at		
		G. I.			
		C. I.			
Nipples	in.	at			
Bushings	to	in.	at		
Red'g	}	Coupl'gs	to	in.	at
Inc'g					
Union	in.	at			
Meter	in.	at			
Lead Joints	at				
Compound Joints	at				
Maintenance Foreman					
Hrs. Water Maint. Man	1	at			
Hrs. Water Maint. Man	2	at			
Hrs. Garage Foreman		at			
Hrs. Labor		at			
Hrs. Compressor	at				
Compensation Ins.	at \$	per C			
Trucking					
Pav't Patch					
O'head					

W-BEACON

St.  
Pl.  
Ave. No. 32


Name of Owner

BRIAN SHEER

Labor and Mat'l. Report

Oct.

19 81

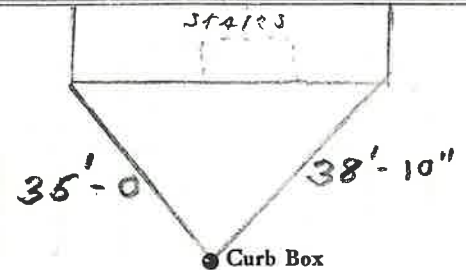

● Curb Box

	Elev. of
Main	Main at tap
Gate at ●	● Gate at

● Curb Box