

LABOR AND MATERIALS

1 Copper } Connection <sup>3/4"</sup> \$ \_\_\_\_\_  
 1 Curb } Cock } <sup>3/4 in.</sup> *ORISEA 1* \$ \_\_\_\_\_  
 1 Service box } Short <sup>3/4 x 4 1/2</sup> } <sup>5'-6'</sup> \$ \_\_\_\_\_  
 Old returned } Long <sup>4 1/2 x 5 1/2</sup> } \$ \_\_\_\_\_  
 24 Ft. <sup>3/4 in.</sup> } Copper } Pipe at \$ \_\_\_\_\_  
 } ~~Cat.~~ }  
 } ~~Cat.~~ }  
 Nipples \_\_\_\_\_ in. at \$ \_\_\_\_\_  
 Bushings \_\_\_\_\_ to \_\_\_\_\_ in. at \$ \_\_\_\_\_  
 Red'g } Coupl'gs \_\_\_\_\_ to \_\_\_\_\_ in. at \$ \_\_\_\_\_  
 Inc'g }  
 Union \_\_\_\_\_ in. at \$ \_\_\_\_\_  
 Meter \_\_\_\_\_ in. at \$ \_\_\_\_\_  
 Lead Joints at \$ \_\_\_\_\_  
 Compound Joints at \$ \_\_\_\_\_  
 Maintenance Foreman \$ \_\_\_\_\_  
 Hrs. Water Maint. Man-1 at \$ \_\_\_\_\_  
 Hrs. Water Maint. Man-2 at \$ \_\_\_\_\_  
 Hrs. Garage Foreman \_\_\_\_\_ at \$ \_\_\_\_\_  
 Hrs. Labor \_\_\_\_\_ at \$ \_\_\_\_\_  
 Hrs. Compressor at \$ \_\_\_\_\_  
 Compensation Ins. at \$ \_\_\_\_\_ per C \$ \_\_\_\_\_  
 Trucking \$ \_\_\_\_\_  
 Pav't Patch \$ \_\_\_\_\_  
*TAP BY ST JOHN & CO* \$ \_\_\_\_\_  
*MAY-10-1976* \$ \_\_\_\_\_  
 O'head \$ \_\_\_\_\_

*E. Beacon*


St. *M.*  
Ave. No. *12*

Name of Owner

*Harold Suckman*

Labor and Mat'l. Report

*MAY 10 1976*

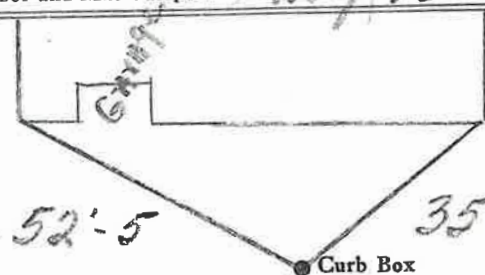

*6"* Main

Elev. of Main at tap *6'*

Gate at ●

● Gate at

● Curb Box

TAX ID # 309.16-11-10