

LABOR AND MATERIALS


| | | | | | |
|-------------------------|---|---------------|-----|---------|----|
| Copper | } | Connection | | | \$ |
| Lead | | | | | |
| Curb | } | Cock | in. | | |
| | | Valve | | | |
| | | T. S. & V. | | | |
| Service box | } | Short 3½ x 4½ | | | |
| Old returned | | Long 4½ x 5½ | | | |
| | | Buff or Rdway | | | |
| 22 Ft. | } | Copper | in. | Pipe at | |
| ¾ in. | | G.I. | | | |
| | | G.I. | | | |
| Nipples | | in. | at | | |
| Bushings | | to | in. | at | |
| Red'g | } | Coupl'gs | to | in. | at |
| Inc'g | | | | | |
| Union | | in. | at | | |
| Meter | | in. | at | | |
| Lead Joints | | at | | | |
| Compound Joints | | at | | | |
| Maintenance Foreman | | | | | |
| Hrs. Water Maint. Man—1 | | at | | | |
| Hrs. Water Maint. Man—2 | | at | | | |
| Hrs. Garage Foreman | | at | | | |
| Hrs. Labor— | | at | | | |
| Hrs. Compressor | | at | | | |
| Compensation Ins. at \$ | | per C | | | |
| Trucking | | | | | |
| Pav't Patch | | | | | |
| | | | | | |
| | | | | | |
| O'head | | | | | |
| | | | | | |

St.
Pl.
Ave. No. 14

E. Beacon

Name of Owner

Labor and Mat'l. Report Aug 1987

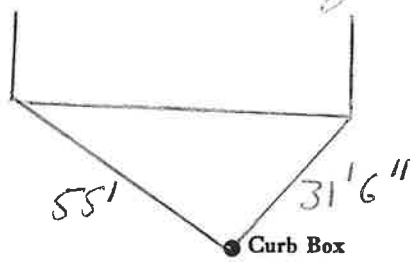

| | |
|------------|-------------|
| | Elev. of |
| Main | Main at tap |
| Gate at ● | ● Gate at |
| ● Curb Box | |