

### LABOR AND MATERIALS


Copper	}	Connection		\$	
Lead					
Curb	}	Cock	} in.	\$	
		Valve			
		T. S. & V.			
Service box	}	Short 3½ x 4½	}	\$	
Old returned		Long 4½ x 5½			
22 Ft. ¾ in.	}	Copper	} Pipe at	\$	
		G.I.			
		C.I.			
Nipples		in. at		\$	
Bushings		to	in. at	\$	
Red'g	}	Coupl'gs	to	in. at	\$
Inc'g					
Union		in. at		\$	
Meter		in. at		\$	
Compound Joints		at		\$	
Maintenance Foreman				\$	
Hrs. Water Maint. Man—1		at		\$	
Hrs. Water Maint. Man—2		at		\$	
Hrs. Garage Foreman		at		\$	
Hrs. Labor		at		\$	
Hrs. Compressor		at		\$	
Trucking				\$	
Pav't Patch				\$	
				\$	
				\$	
				\$	
				\$	

St.  
Pt.  
Ave. No. 16

E. Beacon

Name of Owner  
Heath

Labor and Mat'l. Report 1991

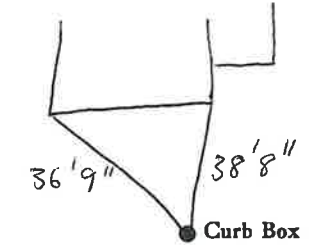

Main Elev. of  
Main at tap

Gate at ● ● Gate at

● Curb Box