


LABOR AND MATERIALS

Copper	} Connection	_____	\$ _____
Lead			
Curb	} Cock Valve T. S. & V. }	_____ in.	\$ _____
Service box		{ Short 3½ x 4½ Long 4½ x 5½ Buff or Rdway }	_____
Old returned			_____
24'8" Ft. 3/4 in.	{ Copper G. I. G. I. }	Pipe at	\$ _____
Nipples	in. at	_____	\$ _____
Bushings	to in. at	_____	\$ _____
Red'g Inc'g	} Coupl'gs	to in. at	\$ _____
Union		in. at	_____
Meter	in. at	_____	\$ _____
Lead Joints	at	_____	\$ _____
Compound Joints	at	_____	\$ _____
Maintenance Foreman		_____	\$ _____
Hrs. Water Maint. Man-1	at	_____	\$ _____
Hrs. Water Maint. Man-2	at	_____	\$ _____
Hrs. Garage Foreman	at	_____	\$ _____
Hrs. Labor	at	_____	\$ _____
Hrs. Compressor	at	_____	\$ _____
Compensation Ins.	at \$ _____ per C	_____	\$ _____
Trucking		_____	\$ _____
Pav't Patch		_____	\$ _____
		_____	\$ _____
		_____	\$ _____
O'head		_____	\$ _____
		_____	\$ _____

Eu. Beason St. Pl. Ave. No. *26-28*
 Name of Owner
 TAX ID # 309.16-11-14

Labor and Mat'l. Report *Aug* 19 *87*

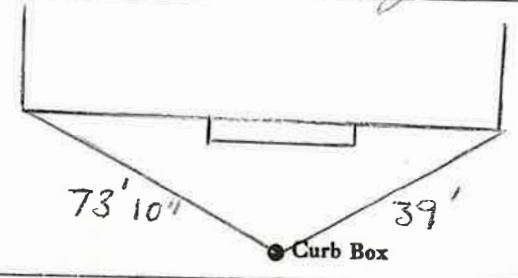

_____ Main	Elev. of Main at tap _____
Gate at • _____	• Gate at _____
_____	_____
	• Curb Box