


LABOR AND MATERIALS

Copper	} Connection	_____	\$ _____	
Lead				
Curb	} Cock	_____ in.	\$ _____	
				} Valve
Service box	} Short 3½ x 4½	_____	\$ _____	
				Old returned
18 Ft. ¾ in.	} Pipe at	_____	\$ _____	
		} Copper		
			} G. I.	
Nipples _____ in. at _____		\$ _____		
Bushings _____ to _____ in. at _____		\$ _____		
Red'g } Inc'g } Coupl'gs _____ to _____ in. at _____		\$ _____		
Union _____ in. at _____		\$ _____		
Meter _____ in. at _____		\$ _____		
Compound Joints at _____		\$ _____		
Maintenance Foreman _____		\$ _____		
Hrs. Water Maint. Man—1 at _____		\$ _____		
Hrs. Water Maint. Man—2 at _____		\$ _____		
Hrs. Garage Foreman _____ at _____		\$ _____		
Hrs. Labor _____ at _____		\$ _____		
Hrs. Compressor at _____		\$ _____		
Trucking _____		\$ _____		
Pav't Patch _____		\$ _____		
_____		\$ _____		
_____		\$ _____		
_____		\$ _____		
_____		\$ _____		

E. Beacon St. 27
~~Pl.~~
Ave. No. 27

Name of Owner
TAX ID # 309.16-14-4

Labor and Mat'l. Report 19 89

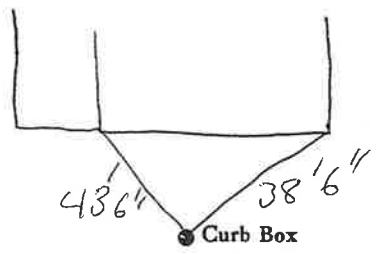

_____ Main	Elev. of Main at tap _____
Gate at ●	● Gate at
_____	_____
● Curb Box	