


LABOR AND MATERIALS

1	Copper	} Connection 2"	\$
	Lead		
1	Curb	} Cock Valve T.S. & V. } 2" in.	\$
1	Service box	} Short 3 1/2 x 4 1/2 } Long 4 1/2 x 5 1/2 }	\$
	Old returned		
23'	23' Ft.	2" in. { Copper } Pipe at	\$
		{ G.F. }	
		{ G.F. }	
	Nipples	in. at	\$
	Bushings	to in. at	\$
	Red'g } Inc'g }	Coupl'gs to in. at	\$
	Union	in. at	\$
	Meter	in. at	\$
			\$
	Compound Joints	at	\$
	Maintenance Foreman		\$
	Hrs. Water Maint. Man	1 at	\$
	Hrs. Water Maint. Man	2 at	\$
	Hrs. Garage Foreman	at	\$
	Hrs. Labor	at	\$
	Hrs. Compressor	at	\$
			\$
	Trucking		\$
	Pav't Patch		\$
			\$
			\$
St. Pl.
BIG CROSS Ave. No. 15

Name of Owner
SCHOOL

Labor and Mat'l. Report OCT. 1927

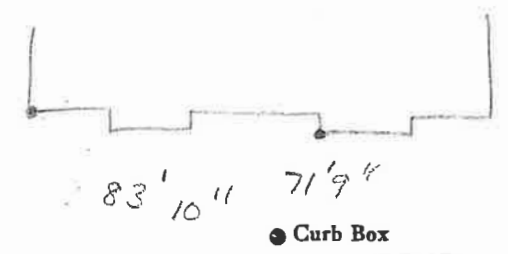

4" Main Elev. of Main at tap 4 1/2'

Gate at ● ● Gate at

TAX ID # 309.11-8-1

● Curb Box

2" TAP