

LABOR AND MATERIALS

1	Copper Lead	Connection	3/4"	\$	2.71
1	Curb	Cock Valve T.S. & V.	3/4" in.	\$	3.93
Same	Service box	Short 3 1/2 x 4 1/2		\$	—
	Old returned	Long 4 1/2 x 5 1/2		\$	—
		Buff or Rdway		\$	—
23	Ft.	Copper Pipe at	3/4" in. 45	\$	10.35
	Nipples	in. at		\$	
	Bushings	to in. at		\$	
	Red'g Inc'g	Coupl'gs to in. at		\$	
	Union	in. at		\$	
	Meter	in. at		\$	
	Lead Joints	at		\$	
	Compound Joints	at		\$	
	Maintenance Foreman			\$	
	Hrs. Water Maint. Man—1	at		\$	
8	Hrs. Water Maint. Man—2	at 1.24		\$	9.92
	Hrs. Garage Foreman	at		\$	
16	Hrs. Labor	at 1.13		\$	18.08
	Hrs. Compressor	at		\$	
	Compensation Ins. at \$	4.29 per C.		\$	1.70
	Trucking			\$	1.50
	Pay't Patch			\$	8.10
	Tap by Gissard			\$	
		9-12-55		\$	
	O'head			\$	
				\$	55.69

47.59

GARROW PLACE


St.
 Pt.
 Ave. No. 21

Name of Owner

BRAYDON

Labor and Mat'l. Report

Sept. 12 1955

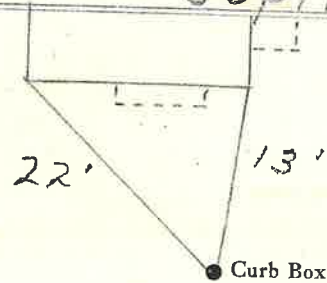

4" Main

Elev. of Main at tap 5'

Gate at •

• Gate at

• Curb Box