

LABOR AND MATERIALS

1	Copper Lead	{ Connection	-----	\$	1.23
1	Curb	{ Cock Valve T.S. & V.	{ 3/4 in.	\$	1.68
1	Service Box	}	Short 3 1/2 x 4 1/2	\$	1.54
	Old returned		Long 4 1/2 x 5 1/2		
			Buff. or Rdway		
18	Ft. 3/4 in.	{ Copper Galv. Iron Cast Iron	} Pipe at 17	\$	3.06
	Nipples	in. at		\$	
	Bushings	to in. at		\$	
	Red'g Inc'g	}	Couplings to in. at	\$	
	Union	in. at		\$	
	Meter	in. at		\$	
	Lead Joints	at		\$	
	Leadite Joints	at		\$	
	Hrs. Foreman	at		\$	
2	Hrs. Chauffeur	at	.62 1/2	\$	1.25
6	Hrs. Tapper	at		\$	3.75
6	Hrs. Labor	at	45	\$	2.70
	Hrs. Labor	at		\$	
3	Hrs. Compressor	at	.65	\$	1.95
	Compensation Ins.			\$.74
	Trucking			\$	1.00
	Builders Use of Water	1/2 cost of rate		\$	2.50
	<i>trip by Hessel</i>			\$	
				\$	
				\$	
				\$	
				\$	20.90

3 - - 1939


St.
Pl.
Ave. No. 35

Big Cross

Name of Owner

Granger

Labor and Mat'l. Report Jan. 9 1939

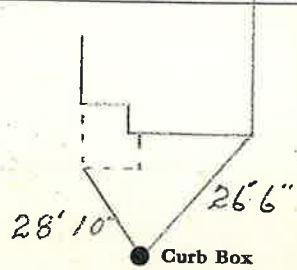

6" Main Elev. of Main at tap 5'

Gate at ● ● Gate at

● Curb Box

New House