


LABOR AND MATERIALS

1	Copper	} Connection	7/4"	\$
	Lead			
1	Curb	} 3/4 in.	\$	
	Cock			
	Valve T.S. & V.			
1	Service box	} Short 3 1/2 x 4 1/2	\$	
	Old returned			
				Long 4 1/2 x 5 1/2
		Buff or Rdway		
320'		} Pipe at	\$	
34'	Ft. 3/4 in.			
				Copper
		G.I.		
		C.I.		
	Nipples	in. at	\$	
	Bushings	to in. at	\$	
	Red'g	} Coupl'gs. to in. at	\$	
	Inc'g			
	Union	in. at	\$	
	Meter	in. at	\$	
	Lead Joints	at	\$	
	Compound Joints	at	\$	
	Maintenance Foreman		\$	
	Hrs. Water Maint. Man-1	at	\$	
	Hrs. Water Maint. Man-2	at	\$	
	Hrs. Garage Foreman	at	\$	
	Hrs. Labor	at	\$	
	Hrs. Compressor	at	\$	
	Compensation Ins. at \$	per C.	\$	
	Trucking		\$	
	Pav't Patch		\$	
	Tap Made 7-16-25		\$	
			\$	
			\$	
	O'head		\$	

Big Cross St. PLTM Ave. No. 7

Name of Owner
LULA GARVIN

Labor and Mat'l. Report July 16 1925

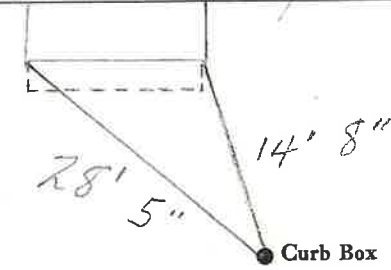

4" Main Elev. of Main at tap 4 1/2'

Gate at • Gate at

TAX ID # 309.11-7-3

Applied for Renewal
Tap 6-15-66. Dog at
Copy.
Curb box land found
Copper Tap
already 6-22-66.