


LABOR AND MATERIALS

1	Copper Lead	} Connection <sup>3/4"</sup>	\$
1	Curb		} Cock Valve } <sup>3/4"</sup> in. \$
		T.S. & V.	
1	Service box	} Short 3 1/2 x 4 1/2 } Long 4 1/2 x 5 1/2 }	\$
	Old returned		
12	Ft. <sup>3/4"</sup> in.	} Copper G.I. G.I. }	Pipe at \$
	Nipples	in. at	\$
	Bushings	to in. at	\$
	Red'g } Inc'g }	Coupl'gs to in. at	\$
	Union	in. at	\$
	Meter	in. at	\$
			\$
	Compound Joints	at	\$
	Maintenance Foreman		\$
	Hrs. Water Maint. Man-1	at	\$
	Hrs. Water Maint. Man-2	at	\$
	Hrs. Garage Foreman	at	\$
	Hrs. Labor	at	\$
	Hrs. Compressor	at	\$
			\$
	Trucking		\$
	Pav't Patch		\$
			\$
			\$
			\$
			\$

BIRCH ~~St.~~  
~~Pl.~~ Ave. No. 24A-B

Name of Owner \_\_\_\_\_

Labor and Mat'l. Report NOV. 1930

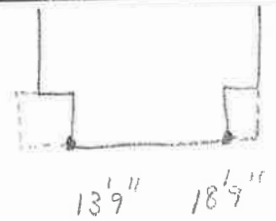

● Curb Box

4" Main Elev. of Main at tap 5'

Gate at ● Gate at

TAX ID # 302.16-18-18

● Curb Box

OLD TAP SHUT OFF AT MAIN