

LABOR AND MATERIALS

1	Copper Lead	Connection	3/4"	\$
1	Curb	Cock Valve T.S. & V.	3/4" in.	\$
1	Service box Old returned	{ Short 3 1/2 x 4 1/2 } { Long 4 1/2 x 5 1/2 }		\$
16	Ft.	{ Copper } { G.I. } { G.I. }	3/4" in. Pipe at	\$
	Nipples	in. at		\$
	Bushings	to in. at		\$
	Red'g Inc'g	Coupl'gs to in. at		\$
	Union	in. at		\$
	Meter	in. at		\$
	Compound Joints	at		\$
	Maintenance Foreman			\$
	Hrs. Water Maint. Man	1 at		\$
	Hrs. Water Maint. Man	2 at		\$
	Hrs. Garage Foreman	at		\$
	Hrs. Labor	at		\$
	Hrs. Compressor	at		\$
	Trucking			\$
	Pav't Patch			\$
				\$
				\$
26 A-B


BIRCH

St. Pl: Ave. No. 26 A-B

Name of Owner

Labor and Mat'l. Report

MAY 1926

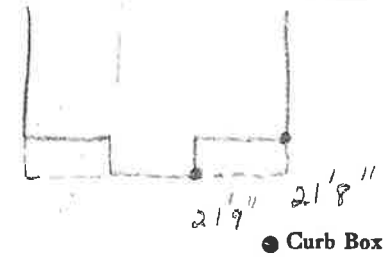

4" Main GAGE AVE. Elev. of Main at tap 6'

Gate at • Gate at

TAX ID # 302.16-18-19

• Curb Box

TAP ON GAGE AVE