


LABOR AND MATERIALS

1	Copper	} Connection	\$	
1	Lead	} Cock	\$	
1	Curb	} Valve	\$	
		} T. S. & V.	\$	in.
1	Service box	} Short 3 1/2 x 4 1/2	\$	
1	Old returned	} Long 4 1/2 x 5 1/2	\$	
		} Buff or Rdway	\$	
12 1/2	Ft.	} Copper	\$	
3/4	in.	} G.I.	\$	
		} C.I.	\$	Pipe at
	Nipples	in. at	\$	
	Bushings	to in. at	\$	
	Red'g	} Coupl'gs	\$	
	Inc'g	} to in. at	\$	
	Union	in. at	\$	
	Meter	in. at	\$	
	Lead Joints	at	\$	
	Compound Joints	at	\$	
	Maintenance Foreman	at	\$	
	Hrs. Water Maint. Man-1	at	\$	
	Hrs. Water Maint. Man-2	at	\$	
	Hrs. Garage Foreman	at	\$	
	Hrs. Labor	at	\$	
	Hrs. Compressor	at	\$	
	Compensation Ins. at \$	per C	\$	
	Trucking	at	\$	
	Pav't Patch	at	\$	
	O'head	at	\$	

St.
Pl.
Ave. No. 10

BIRCH
Name of Owner

Labor and Mat'l. Report 19

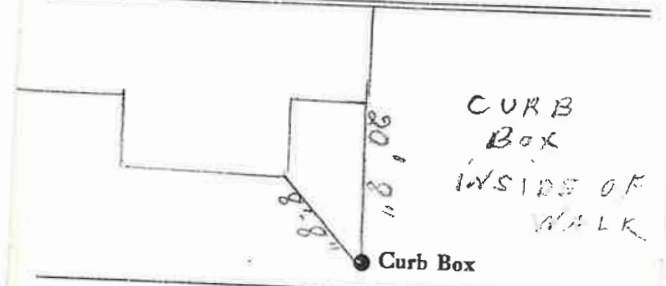

Elev. of
Main at tap

Main Gate at

Gate at Gate at

● Curb Box

TAX ID # 302.16-18-11