

LABOR AND MATERIALS

1	Copper Lead	} Connection $\frac{3}{4}$ "	\$
1	Curb		} Cock Valve T.S. & V. $\frac{3}{4}$ " in.
1	Service box Old returned	} Short $3\frac{1}{2}$ x $4\frac{1}{2}$ Long $4\frac{1}{2}$ x $5\frac{1}{2}$ Buff or Rdway	
18	Ft $\frac{3}{4}$ " in.		} Copper C.I. } Pipe at
	Nipples	in. at	
	Bushings	to in. at	\$
	Red'g } Inc'g }	} Coupl'gs to in. at	\$
	Union		
	Meter	in. at	\$
	Lead Joints	at	\$
	Compound Joints	at	\$
	Maintenance Foreman		\$
	Hrs. Water Maint. Man-1	at	\$
	Hrs. Water Maint. Man-2	at	\$
	Hrs. Garage Foreman	at	\$
	Hrs. Labor	at	\$
	Hrs. Compressor	at	\$
	Compensation Ins.	at \$ per C	\$
	Trucking		\$
	Pav't Patch		\$
	O'head		\$


St. **A-B**
Pl.
Ave. No. **11**

BIRCH

Name of Owner

Labor and Mat'l. Report

19

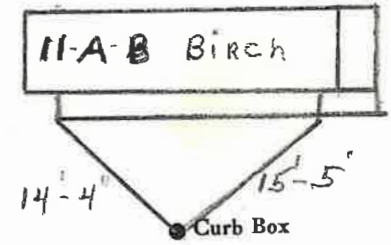

$\frac{3}{4}$ " Main

Elev. of Main at tap **6'**

Gate at ●

● Gate at

● Curb Box

TAX ID # 302.20-6-16