

LABOR AND MATERIALS


1	Copper	}	Connection		\$		
	Lead						
1	Curb	}	Cock	in.	\$		
			Valve				
			T.S. & V.				
1	Service box	}	Short 3 1/2 x 4 1/2				
	Old returned		Long 4 1/2 x 5 1/2				
			Buff or Rdway			\$	
28	Ft. 3/4 in.	}	Copper	Pipe at	\$		
			C.I.				
			C.I.				
	Nipples	in.	at		\$		
	Bushings	to	in.	at	\$		
	Red'g	}	Coupl'gs	to	in.	at	\$
	Inc'g						
	Union	in.	at		\$		
	Meter	in.	at		\$		
	Lead Joints	at			\$		
	Compound Joints	at			\$		
	Maintenance Foreman				\$		
	Hrs. Water Maint. Man	1	at		\$		
	Hrs. Water Maint. Man	2	at		\$		
	Hrs. Garage Foreman		at		\$		
	Hrs. Labor		at		\$		
	Hrs. Compressor		at		\$		
	Compensation Ins.	at \$	per C		\$		
	Trucking				\$		
	Pav't Patch				\$		
					\$		
					\$		
	O'head				\$		
					\$		

St.
Pl.
Ave. No. 1

BOWMAN

Name of Owner LUTHERAN CHURCH
OF THE GOOD SHEPHERD

Labor and Mat'l. Report 19

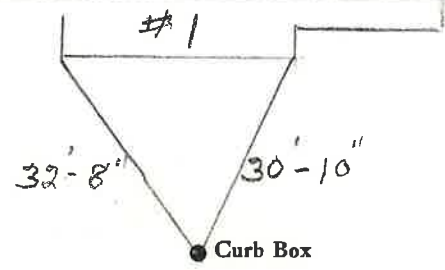

6" Main Elev. of Main at tap 5'

Gate at ● ● Gate at

● Curb Box