


LABOR AND MATERIALS

1	Copper	Connection	3/4"	\$
1	Curb	Cook Valve	3/4 in. OYISEA1	
1	Service box	Short 3 1/2 x 4 1/2	} 5' x 6'	
	Old returned	Long 4 1/2 x 5 1/2		
		Buf. or Rdway		
50	3/4 in.	Copper	Pipe at	\$
	Nipples	in. at		\$
	Bushings	to in. at		\$
	Red'g			
	Inc'g	Coupl'gs to in. at		\$
	Union	in. at		\$
	Meter	in. at		\$
	Lead Joints	at		\$
	Compound Joints	at		\$
	Maintenance Foreman			\$
	Hrs. Water Maint. Man	1 at		\$
	Hrs. Water Maint. Man	2 at		\$
	Hrs. Garage Foreman	at		\$
	Hrs. Labor	at		\$
	Hrs. Compressor	at		\$
	Compensation Ins.	at \$ per C		\$
	Trucking			\$
	Pav't Patch			\$
	TAP MADE BY BEECHER & CO			\$
	Aug-6-1975			\$
	O'head			\$

BOWMAN Ave. No. 13

Name of Owner
Lloyd Kingsley

Labor and Mat'l. Report Aug 6 1975

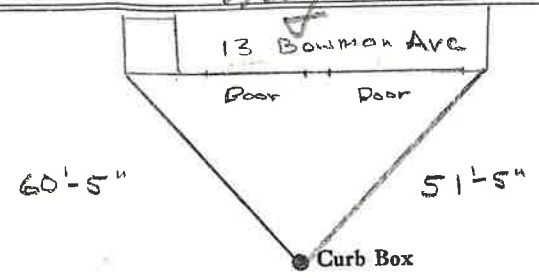

6" Main Elev. of Main at tap 6'

Gate at • Gate at •

