

LABOR AND MATERIALS

1	Copper Lead	Connection	3/4"	\$	
1	Curb	Cock Valve T.S. & V.	3/4" in.	\$	
1	Service box Old returned	Short 3 1/2 x 4 1/2 Long 4 1/2 x 5 1/2		\$	
9	Ft.	3/4" in. Copper C.I. C.I.	Pipe at	\$	
	Nipples	in. at		\$	
	Bushings	to in. at		\$	
	Red'g } Inc'g }	Coupl'gs	to in. at	\$	
	Union	in. at		\$	
	Meter	in. at		\$	
	Compound Joints	at		\$	
	Maintenance Foreman			\$	
	Hrs. Water Maint. Man	—1 at		\$	
	Hrs. Water Maint. Man	—2 at		\$	
	Hrs. Garage Foreman	at		\$	
	Hrs. Labor	at		\$	
	Hrs. Compressor	at		\$	
	Trucking			\$	
	Pav't Patch			\$	
				\$	
				\$	

BOWMAN

St.
 Pt.
 Ave. No. 2

Name of Owner

Labor and Mat'l. Report

MAY 19 28

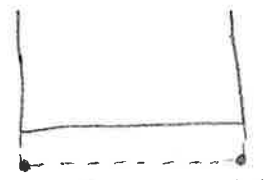

25' 3" 16' 9"
 ● Curb Box

6" Main

Elev. of Main at tap 45'

Gate at ●

● Gate at

● Curb Box