

LABOR AND MATERIALS

1	Copper	} Connection	3/4"	\$	
	Lead				
1	Curb	} Cock	3/4 in.	\$	
					} Valve
1	Service box	} Short 3 1/2 x 4 1/2		\$	
	Old returned				} Long 4 1/2 x 5 1/2
26	Ft. 3/4 in.	} Copper	} Pipe at	\$	
					} G. I.
	Nipples	in. at	\$		
	Bushings	to in. at	\$		
	Red'g	} Coupl'gs	to in. at	\$	
	Inc'g				
	Union	in. at	\$		
	Meter	in. at	\$		
	Lead Joints at		\$		
	Compound Joints at		\$		
	Maintenance Foreman		\$		
	Hrs. Water Maint. Man-1 at		\$		
	Hrs. Water Maint. Man-2 at		\$		
	Hrs. Garage Foreman at		\$		
	Hrs. Labor at		\$		
	Hrs. Compressor at		\$		
	Compensation Ins. at \$	per C	\$		
	Trucking		\$		
	Pav't Patch		\$		
	Tap by Gifford & Co.		\$		
	4-2-59.		\$		
	O'head		\$		


Bowman

St-  
Pl-  
Ave. No. 3

Name of Owner

Burns

Labor and Mat'l. Report April 2 1959

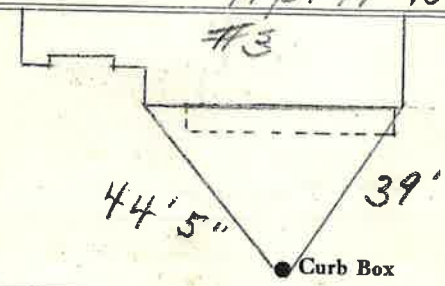

6" Main

Elev. of Main at tap 5 1/2'

Gate at ●

● Gate at

● Curb Box