

LABOR AND MATERIALS


1	Copper Lead	} Connection ^{3/4"}	\$
1	Curb		} Cock Valve } ^{3/4"} in.
		T.S. & V.	
1	Service box Old returned	} Short 3 1/2 x 4 1/2 } Long 4 1/2 x 3 1/2 }	\$
25	Ft. ^{3/4"} in.		} Copper C.I. } Pipe at
		C.I.	
	Nipples	in. at	\$
	Bushings	to in. at	\$
	Red'g } Inc'g }	Coupl'gs to in. at	\$
	Union	in. at	\$
	Meter	in. at	\$
	Compound Joints	at	\$
	Maintenance Foreman		\$
	Hrs. Water Maint. Man—1	at	\$
	Hrs. Water Maint. Man—2	at	\$
	Hrs. Garage Foreman	at	\$
	Hrs. Labor—	at	\$
	Hrs. Compressor	at	\$
	Trucking		\$
	Pav't Patch		\$
			\$
			\$
			\$
			\$

BOWMAN

St.
Pl.
Ave. No. 5

Name of Owner
TAX ID # 302.15-3-5

Labor and Mat'l. Report MAY 19 34

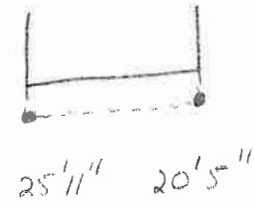

● Curb Box

6" Main Elev. of
Main at tap 6 1/2'

Gate at ● ● Gate at

● Curb Box