

LABOR AND MATERIALS


	Copper	Connection	$\frac{3}{4}$ "			
	Lead					\$
	Curb	Cock Valve	$\frac{3}{4}$ "	in.		\$
		T.S. & V.				
	Service box	Short	$3\frac{1}{2}$ x $4\frac{1}{2}$	}		\$
	Old returned	Long	$4\frac{1}{2}$ x $5\frac{1}{2}$	}		
	14 Ft.	$\frac{3}{4}$ " in.	Copper	}	Pipe at	\$
			G.I.	}		
			G.I.	}		
	Nipples	in. at				\$
	Bushings	to in. at				\$
	Red'g					
	Inc'g	Coupl'gs	to in. at			\$
	Union	in. at				\$
	Meter	in. at				\$
						\$
	Compound Joints	at				\$
	Maintenance Foreman					\$
	Hrs. Water Maint. Man	—1 at				\$
	Hrs. Water Maint. Man	—2 at				\$
	Hrs. Garage Foreman	at				\$
	Hrs. Labor	at				\$
	Hrs. Compressor	at				\$
						\$
	Trucking					\$
	Pav't Patch					\$
						\$
						\$
						\$
						\$

BOWMAN

St. _____
 Pf. _____
 Ave. No. 8

Name of Owner _____

Labor and Mat'l. Report APR. 1929

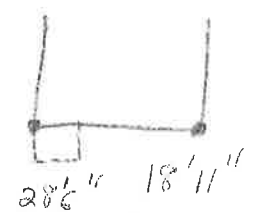

● Curb Box

6" Main Elev. of Main at tap 6'

Gate at ● ● Gate at

● Curb Box