

### LABOR AND MATERIALS


1	Copper <del>Lead</del>	} Connection	$\frac{3}{4}$ "		\$
1	Curb	} Cock Valve T.S. & V.	$\frac{3}{4}$ " in.		\$
1	Service box Old returned	} Short $3\frac{1}{2}$ x $4\frac{1}{2}$ Long $4\frac{1}{2}$ x $5\frac{1}{2}$			\$
25'	$\frac{3}{4}$ "	} Copper <del>C.I.</del>	} Pipe at		\$
	Nipples	in. at			\$
	Bushings	to in. at			\$
	Red'g Inc'g	Coupl'gs	to in. at		\$
	Union	in. at			\$
	Meter	in. at			\$
	Compound Joints	at			\$
	Maintenance Foreman				\$
	Hrs. Water Maint. Man-1	at			\$
	Hrs. Water Maint. Man-2	at			\$
	Hrs. Garage Foreman	at			\$
	Hrs. Labor	at			\$
	Hrs. Compressor	at			\$
	Trucking				\$
	Pav't Patch				\$
					\$
					\$
-St.  
-Pl.  
Ave. No. 9

BOWMAN

Name of Owner \_\_\_\_\_

Labor and Mat'l. Report MAY 1935

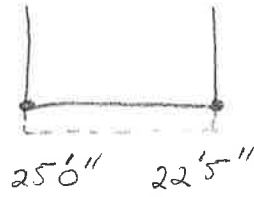

● Curb Box

$6$ " Main Elev. of  
Main at tap  $5\frac{1}{2}$ '

Gate at ● ● Gate at

● Curb Box